

Public Notice – Proposed Traffic or Parking Amendment

Members of the community are invited to view and make comment on the following proposed traffic or parking amendment.

Reference No	TR2023/00426
Road/s	Collier Street, Wallsend
Traffic Engineer	Daria Chen, Traffic Engineer
Contact No	4974 2000
Approval Authority	City of Newcastle
Submission Period Closes	19 April 2023

Exhibition

City of Newcastle is proposing the following traffic or parking amendment:

It is proposed to remove the existing 2P parking restrictions on both sides of Collier Street to provide unrestricted on-street parking for the street.

The existing 2P parking restriction on both sides of the named street was approved by Newcastle City Traffic Committee in 2002 following consultation with the residents in the streets surrounding the Wallsend Hospital Campus. It was installed to minimise the impacts to safety and amenity caused by Wallsend Hospital staff parking in the area.

It is noted that the Hospital car park at the end of Shield Lane has been upgraded, with parking demand in Collier Street observed as being significantly reduced because of this.

Submissions

Any person, during the specified submission period, may make submissions to the City of Newcastle concerning the proposed traffic or parking amendment. The submissions must specify:

- the reference number TR2023/00426,
- the submitter's name, residential address, contact number; and preferably an email address, and
- whether the submission is in support or objection of the proposal.

Submissions must be made in writing and should be lodged via the [online submission form](#) on City of Newcastle's website.

Alternatively, submissions can be made by mailed to PO Box 489, Newcastle NSW 2300 or delivered in person to the Customer Service Centre at 12 Stewart Avenue, Newcastle West NSW 2302.


All submissions received are considered 'Open Access Information' under the Government Information (Public Access) Act 2009 (GIPA) and therefore may be made available to the public.

Following the closure of the submission period, the proposal and submissions received will be considered by the Newcastle City Traffic Committee at an upcoming meeting.

Submission closing date

Submissions must be received by 5.00 pm on 19 April 2023.

Notice published on City of Newcastle website on 4 April 2023.

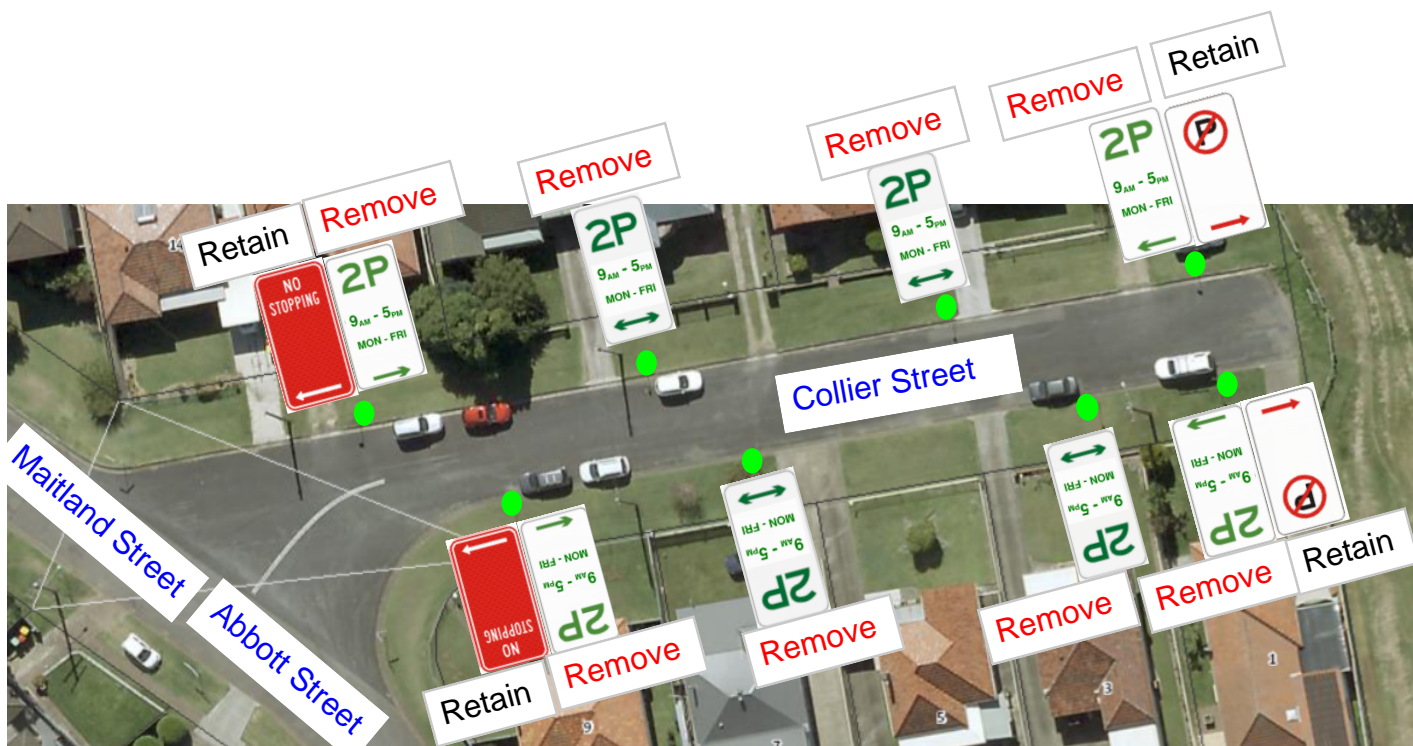

Collier Street, Wallsend

- - Utility Pole
- - Existing Post
- - Proposed Post



New Signs Inventory